



LEFT EDGELINES


(DIVIDED HIGHWAYS)

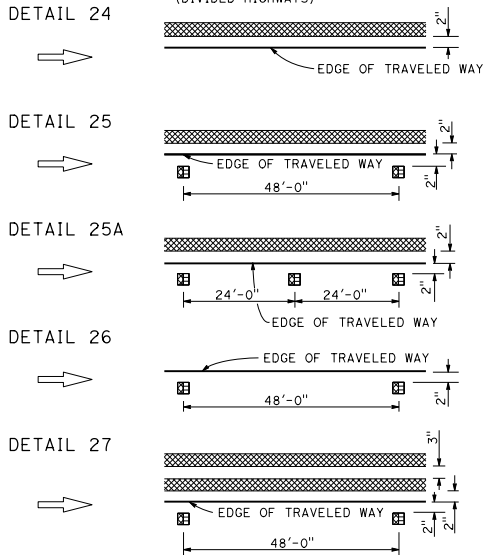


RIGHT EDGELINES

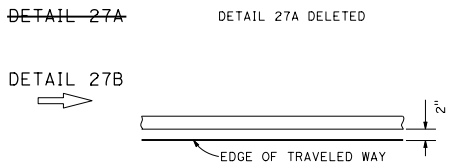

RIGHT EDGELINE EXTENSION THROUGH INTERSECTIONS

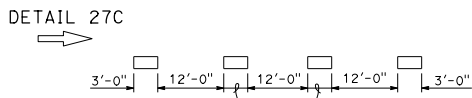


MEDIAN ISLANDS

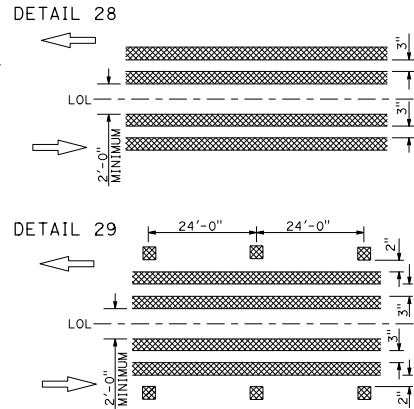

~~DETAIL 30~~ **DETAIL 30 DELETED**

TWO-WAY LEFT TURN LANES

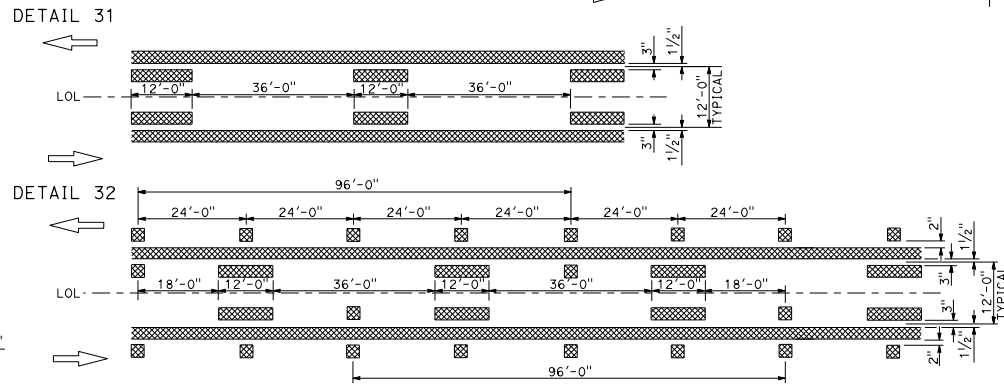

~~DETAIL 33~~ **DETAIL 33 DELETED**

LEGEND


MARKERS

- ☒ TYPE D TWO-WAY YELLOW RETROREFLECTIVE
- ☒ TYPE H ONE-WAY YELLOW RETROREFLECTIVE
- ☒ TYPE RY RED-YELLOW RETROREFLECTIVE


LINES

- ▭ 6" WHITE
- ▨ 6" YELLOW

INTERSECTION TREATMENTS

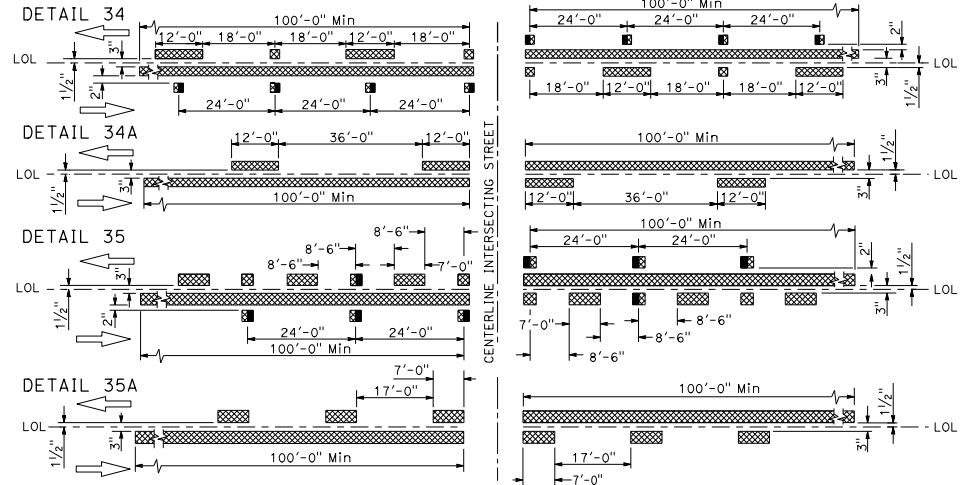

MARKER DETAILS

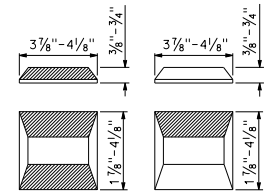

TYPE RY AND TYPE D **TYPE H**

▨ RETROREFLECTIVE FACE

STATE OF CALIFORNIA
DEPARTMENT OF TRANSPORTATION

PAVEMENT MARKERS AND TRAFFIC LINES TYPICAL DETAILS

NO SCALE

RSP A20B DATED APRIL 20, 2018 SUPERSEDES RSP A20B DATED JULY 21, 2017 AND STANDARD PLAN A20B DATED OCTOBER 30, 2015 - PAGE 13 OF THE STANDARD PLANS BOOK DATED 2015.

REVISED STANDARD PLAN RSP A20B

DIST	COUNTY	ROUTE	POST MILES TOTAL PROJECT	SHEET NO.	TOTAL SHEETS

Atifa Ferouz
REGISTERED CIVIL ENGINEER

April 20, 2018
PLANS APPROVAL DATE

Atifa Ferouz
No. C80402
EXP. 3-31-19
CIVIL

THE STATE OF CALIFORNIA OR ITS OFFICERS OR AGENTS SHALL NOT BE RESPONSIBLE FOR THE ACCURACY OR COMPLETENESS OF SCANNED COPIES OF THIS PLAN SHEET.

2015 REVISED STANDARD PLAN RSP A20B